
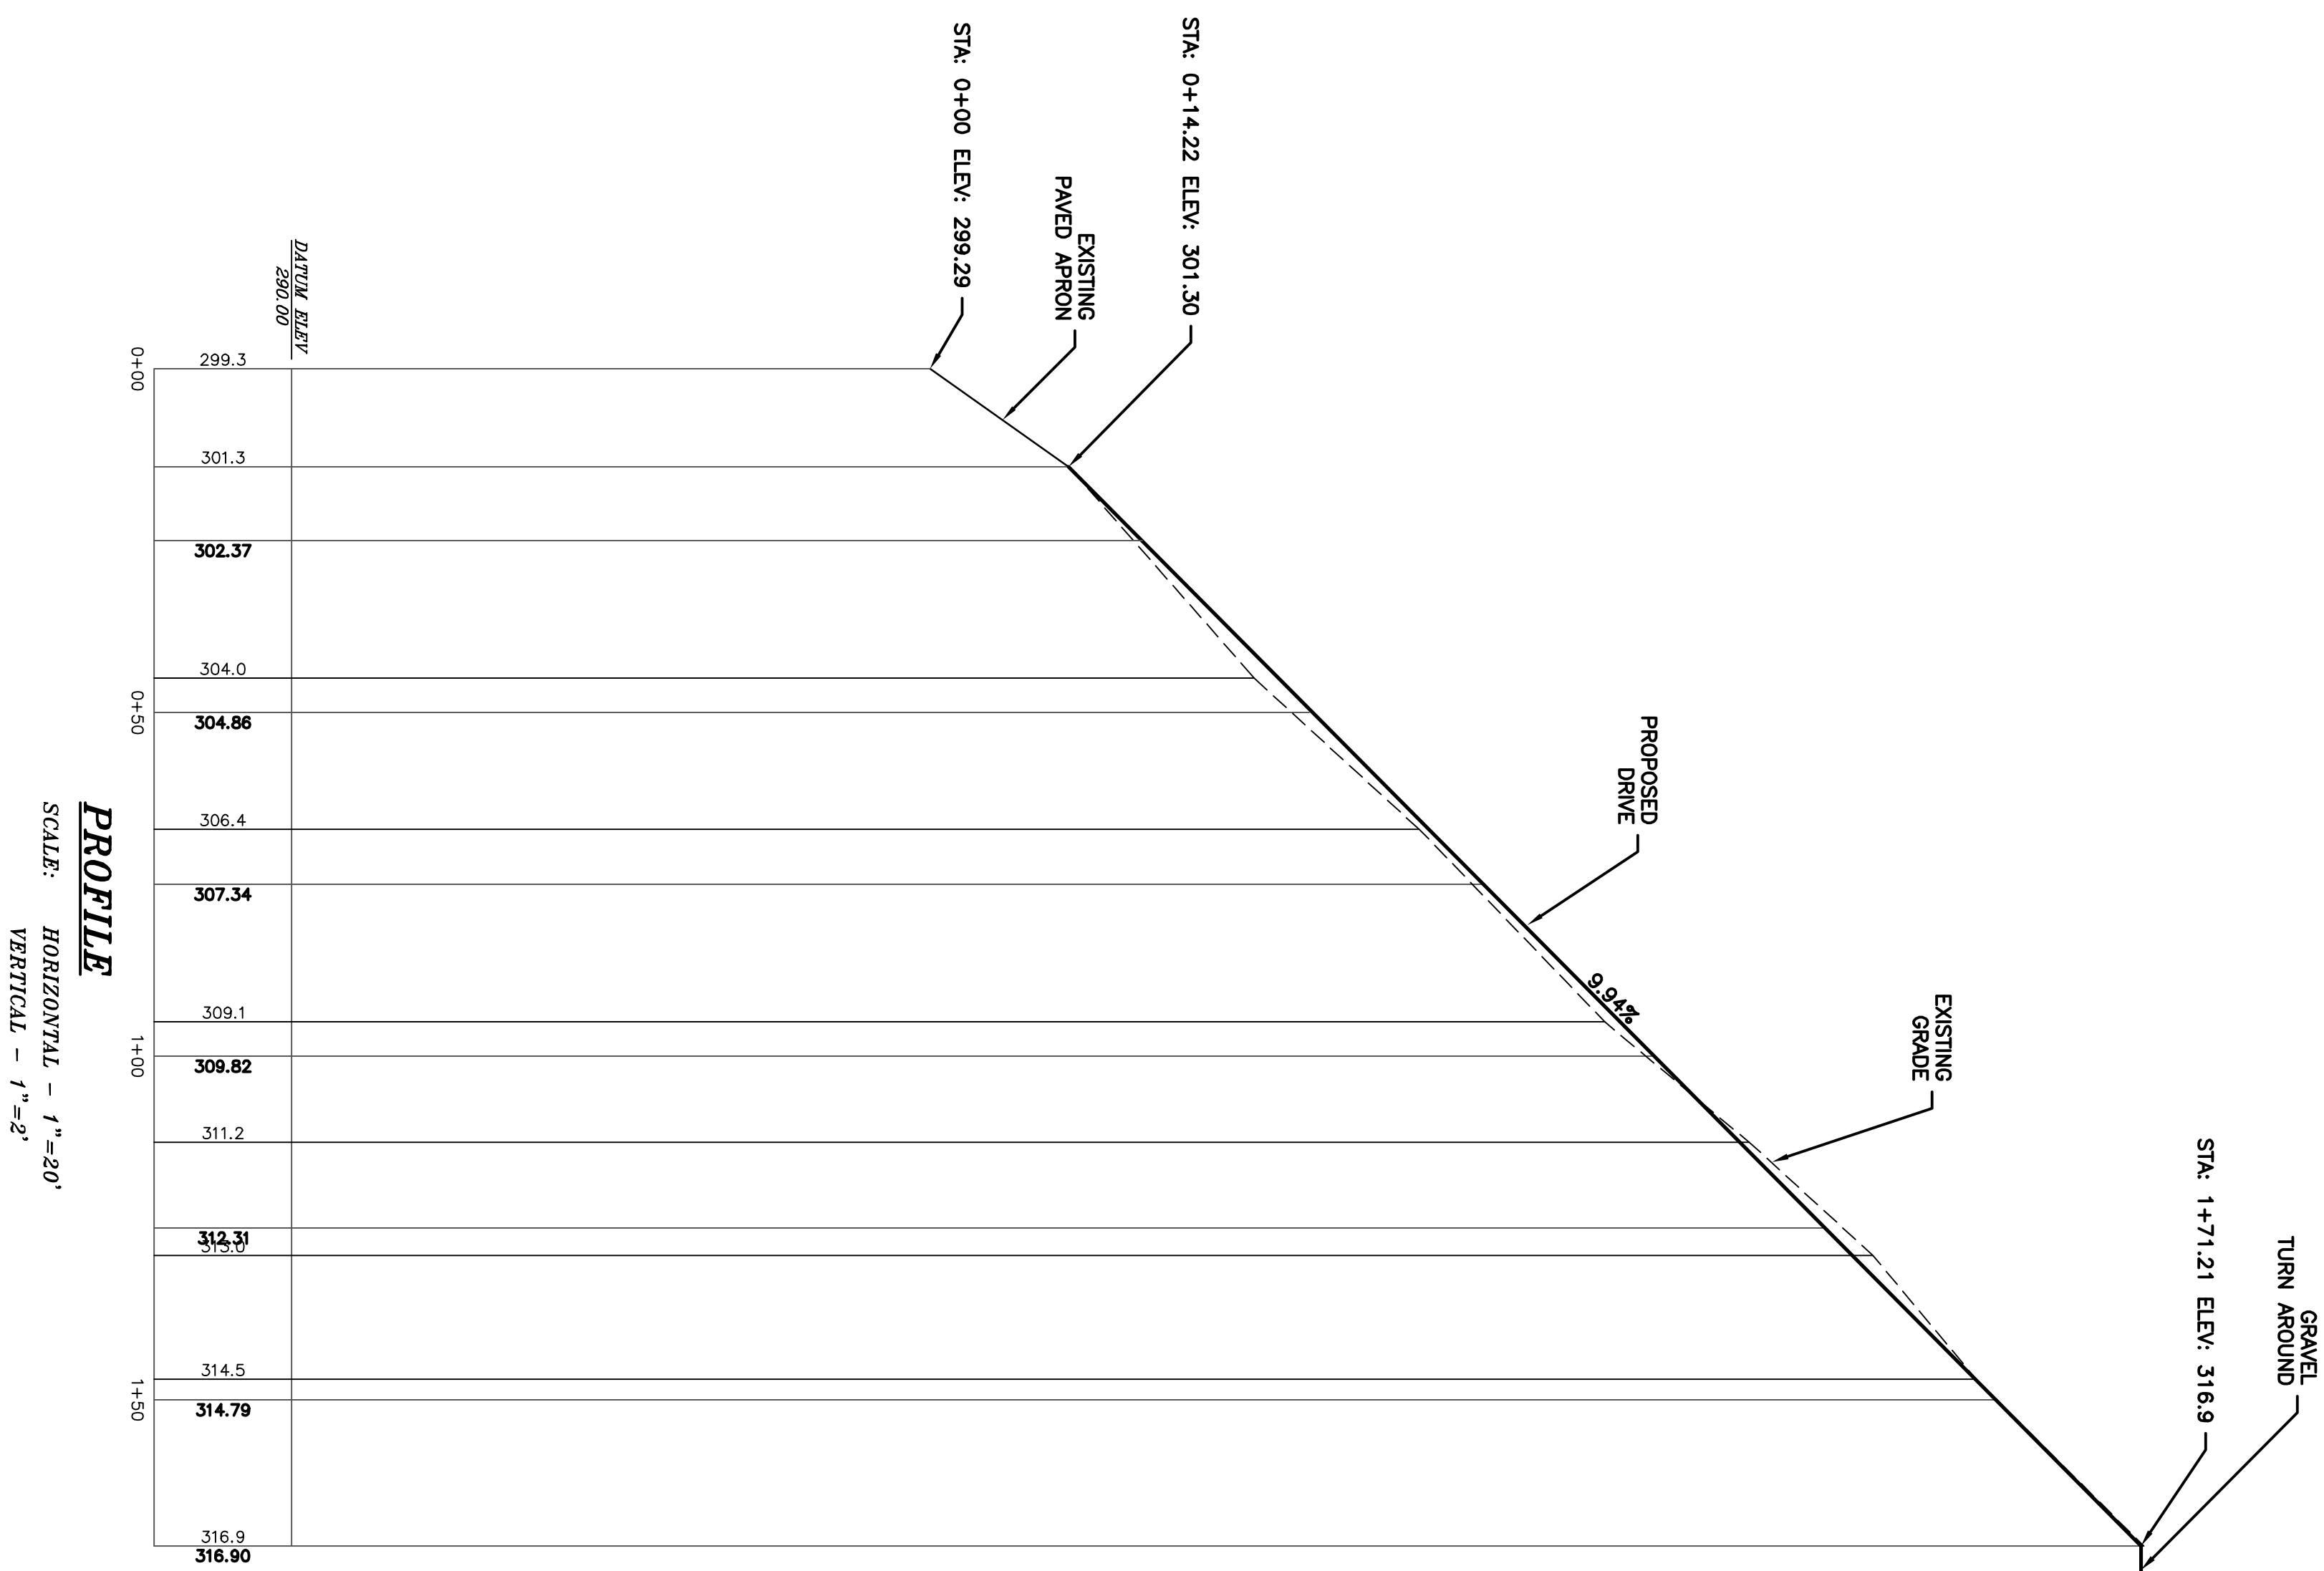
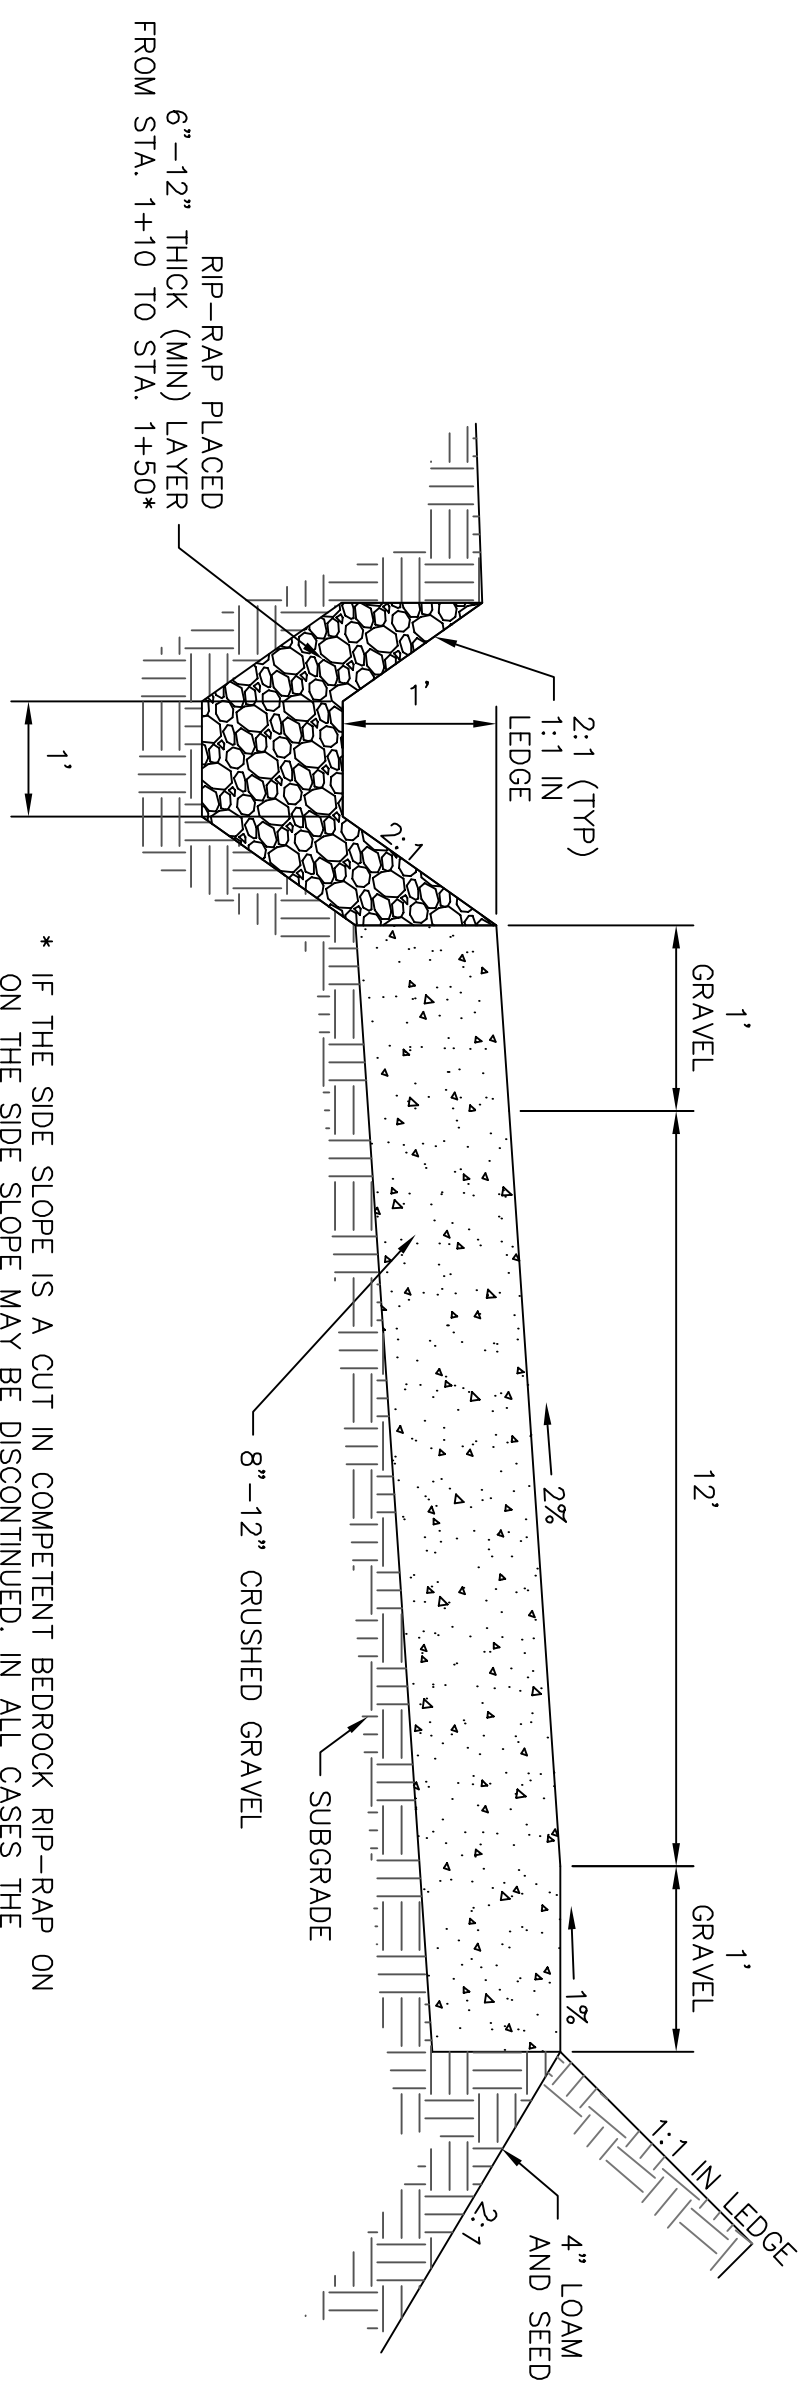


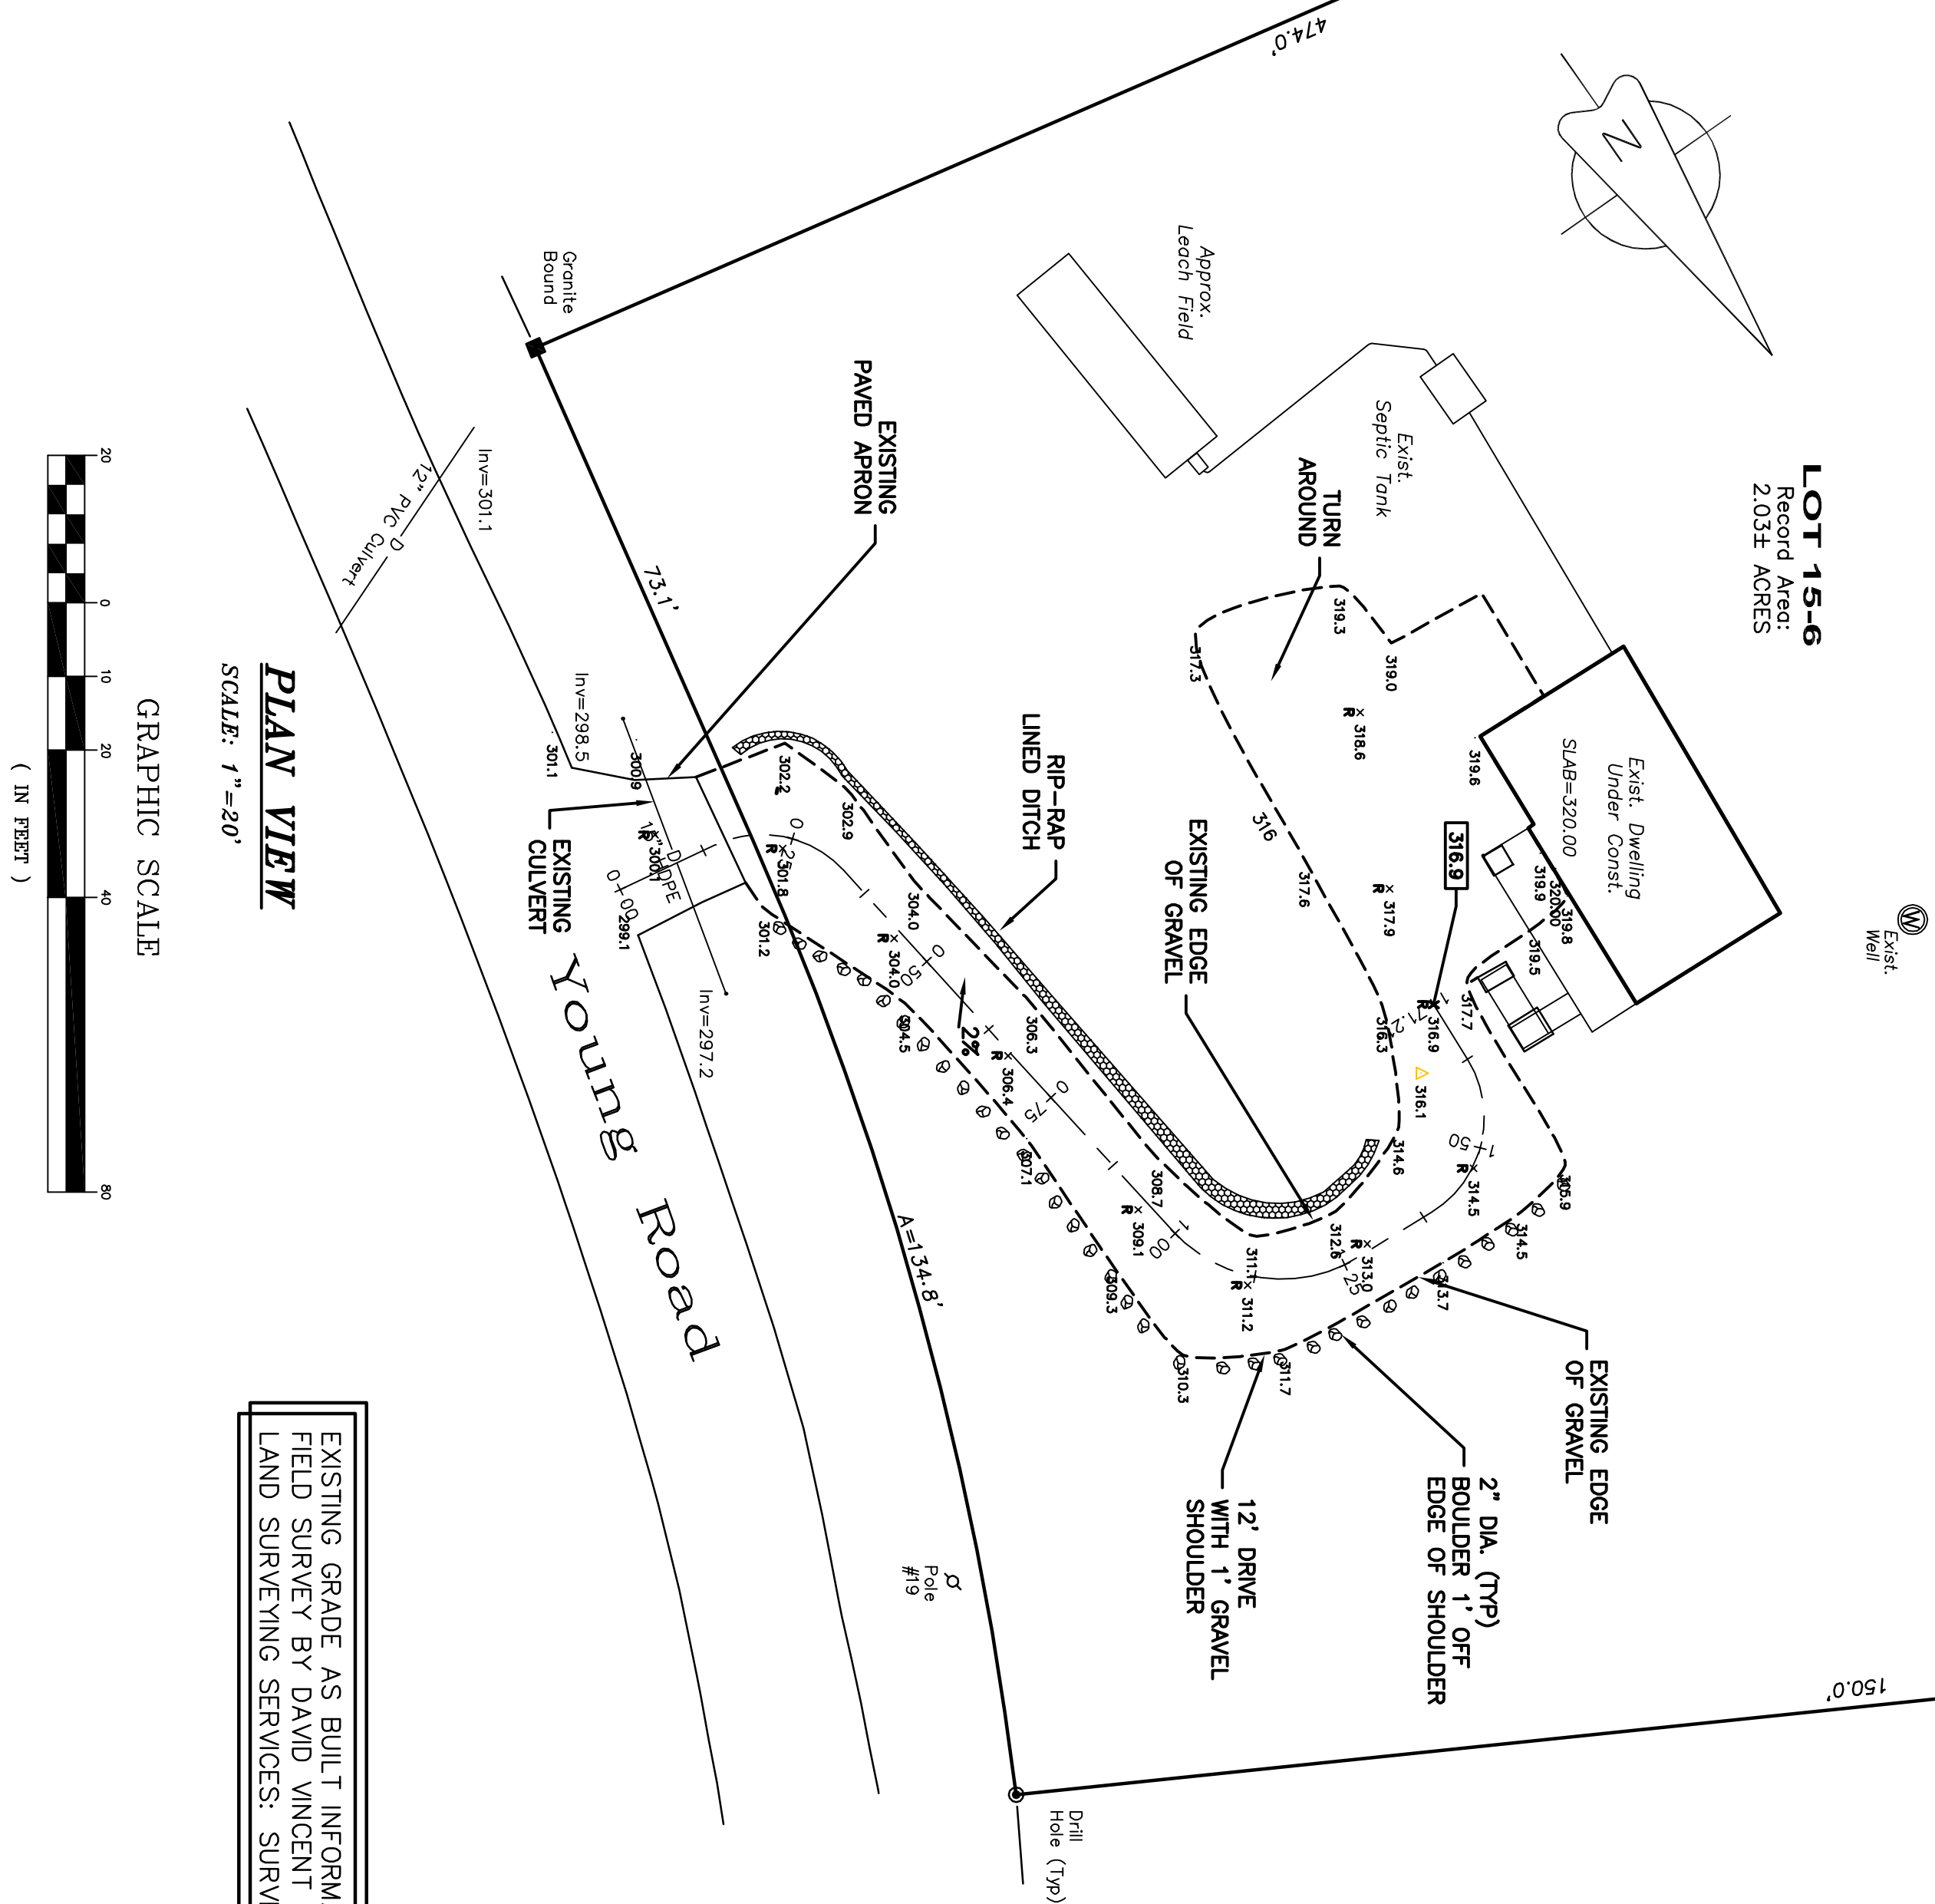

DATE: 1-29-15					
SCALE: AS SHOWN					
DRAWN BY: SRD					
DESIGN BY: SD/SJH	3	ASBUILT GRADES 2/27/15	SJH	2-27-15	 HAIGHT ENGINEERING, PLLC CIVIL ENGINEERS P.O. BOX 1166, 181 WATSON ROAD DOVER, NEW HAMPSHIRE 603.750.4266. FAX 603.749.7348
APPROVED BY: SJH	2	REVISED GRADING	SJH	2-24-15	
PROJECT NO: 1502	1	SHOW GRADING	SJH	2-19-15	
FILE: SITE.DWG	NO.	REVISION	APP'D	DATE	

WAIVER REQUEST – RESIDENTIAL DRIVEWAY GRADE

J.L. Powell Construction, LLC
P. O. Box 4225
Windham, NH 03087
603-303-6270

**Lot 15-6 Young Road
Residential Driveway
Barrington, NH**

C-1