


REVISIONS	
NO.	DESCRIPTION

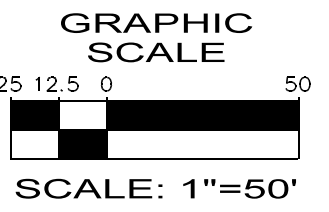

**N.H. LAND Consultants**  
 SURVEYING • LAND PLANNING • REAL ESTATE  
 A Veteran Owned Company

683C FIRST NH TURNPIKE, NORTHWOOD, NH 03261 PH. 603-942-9220 WEBSITE: NH.LANDCONSULTANTS.COM

THATCHER WAY AS-BUILT  
 TAX MAP 233 LOTS 30-01 THRU 30-14  
**BAR HOMES, INC.**  
 P.O. BOX 334  
 STRATHAM, NH 03885

STRAFFORD CO.  
 JOB NO: 013.00  
 DATE: NOVEMBER 17, 2020

**AB-1**  
 SHT. 1 of 1



Drawing Name: P:\NH\Reserve\as-built\THATCHER WAY\THATCHER WAY AS-BUILT.dwg  
 Project: 013.00-THATCHER WAY  
 Date: 11/17/2020  
 Author: FRANKIEWICZ  
 Plotter: HPGLASER